
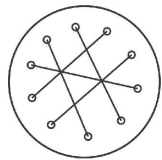


AVAILABLE #300

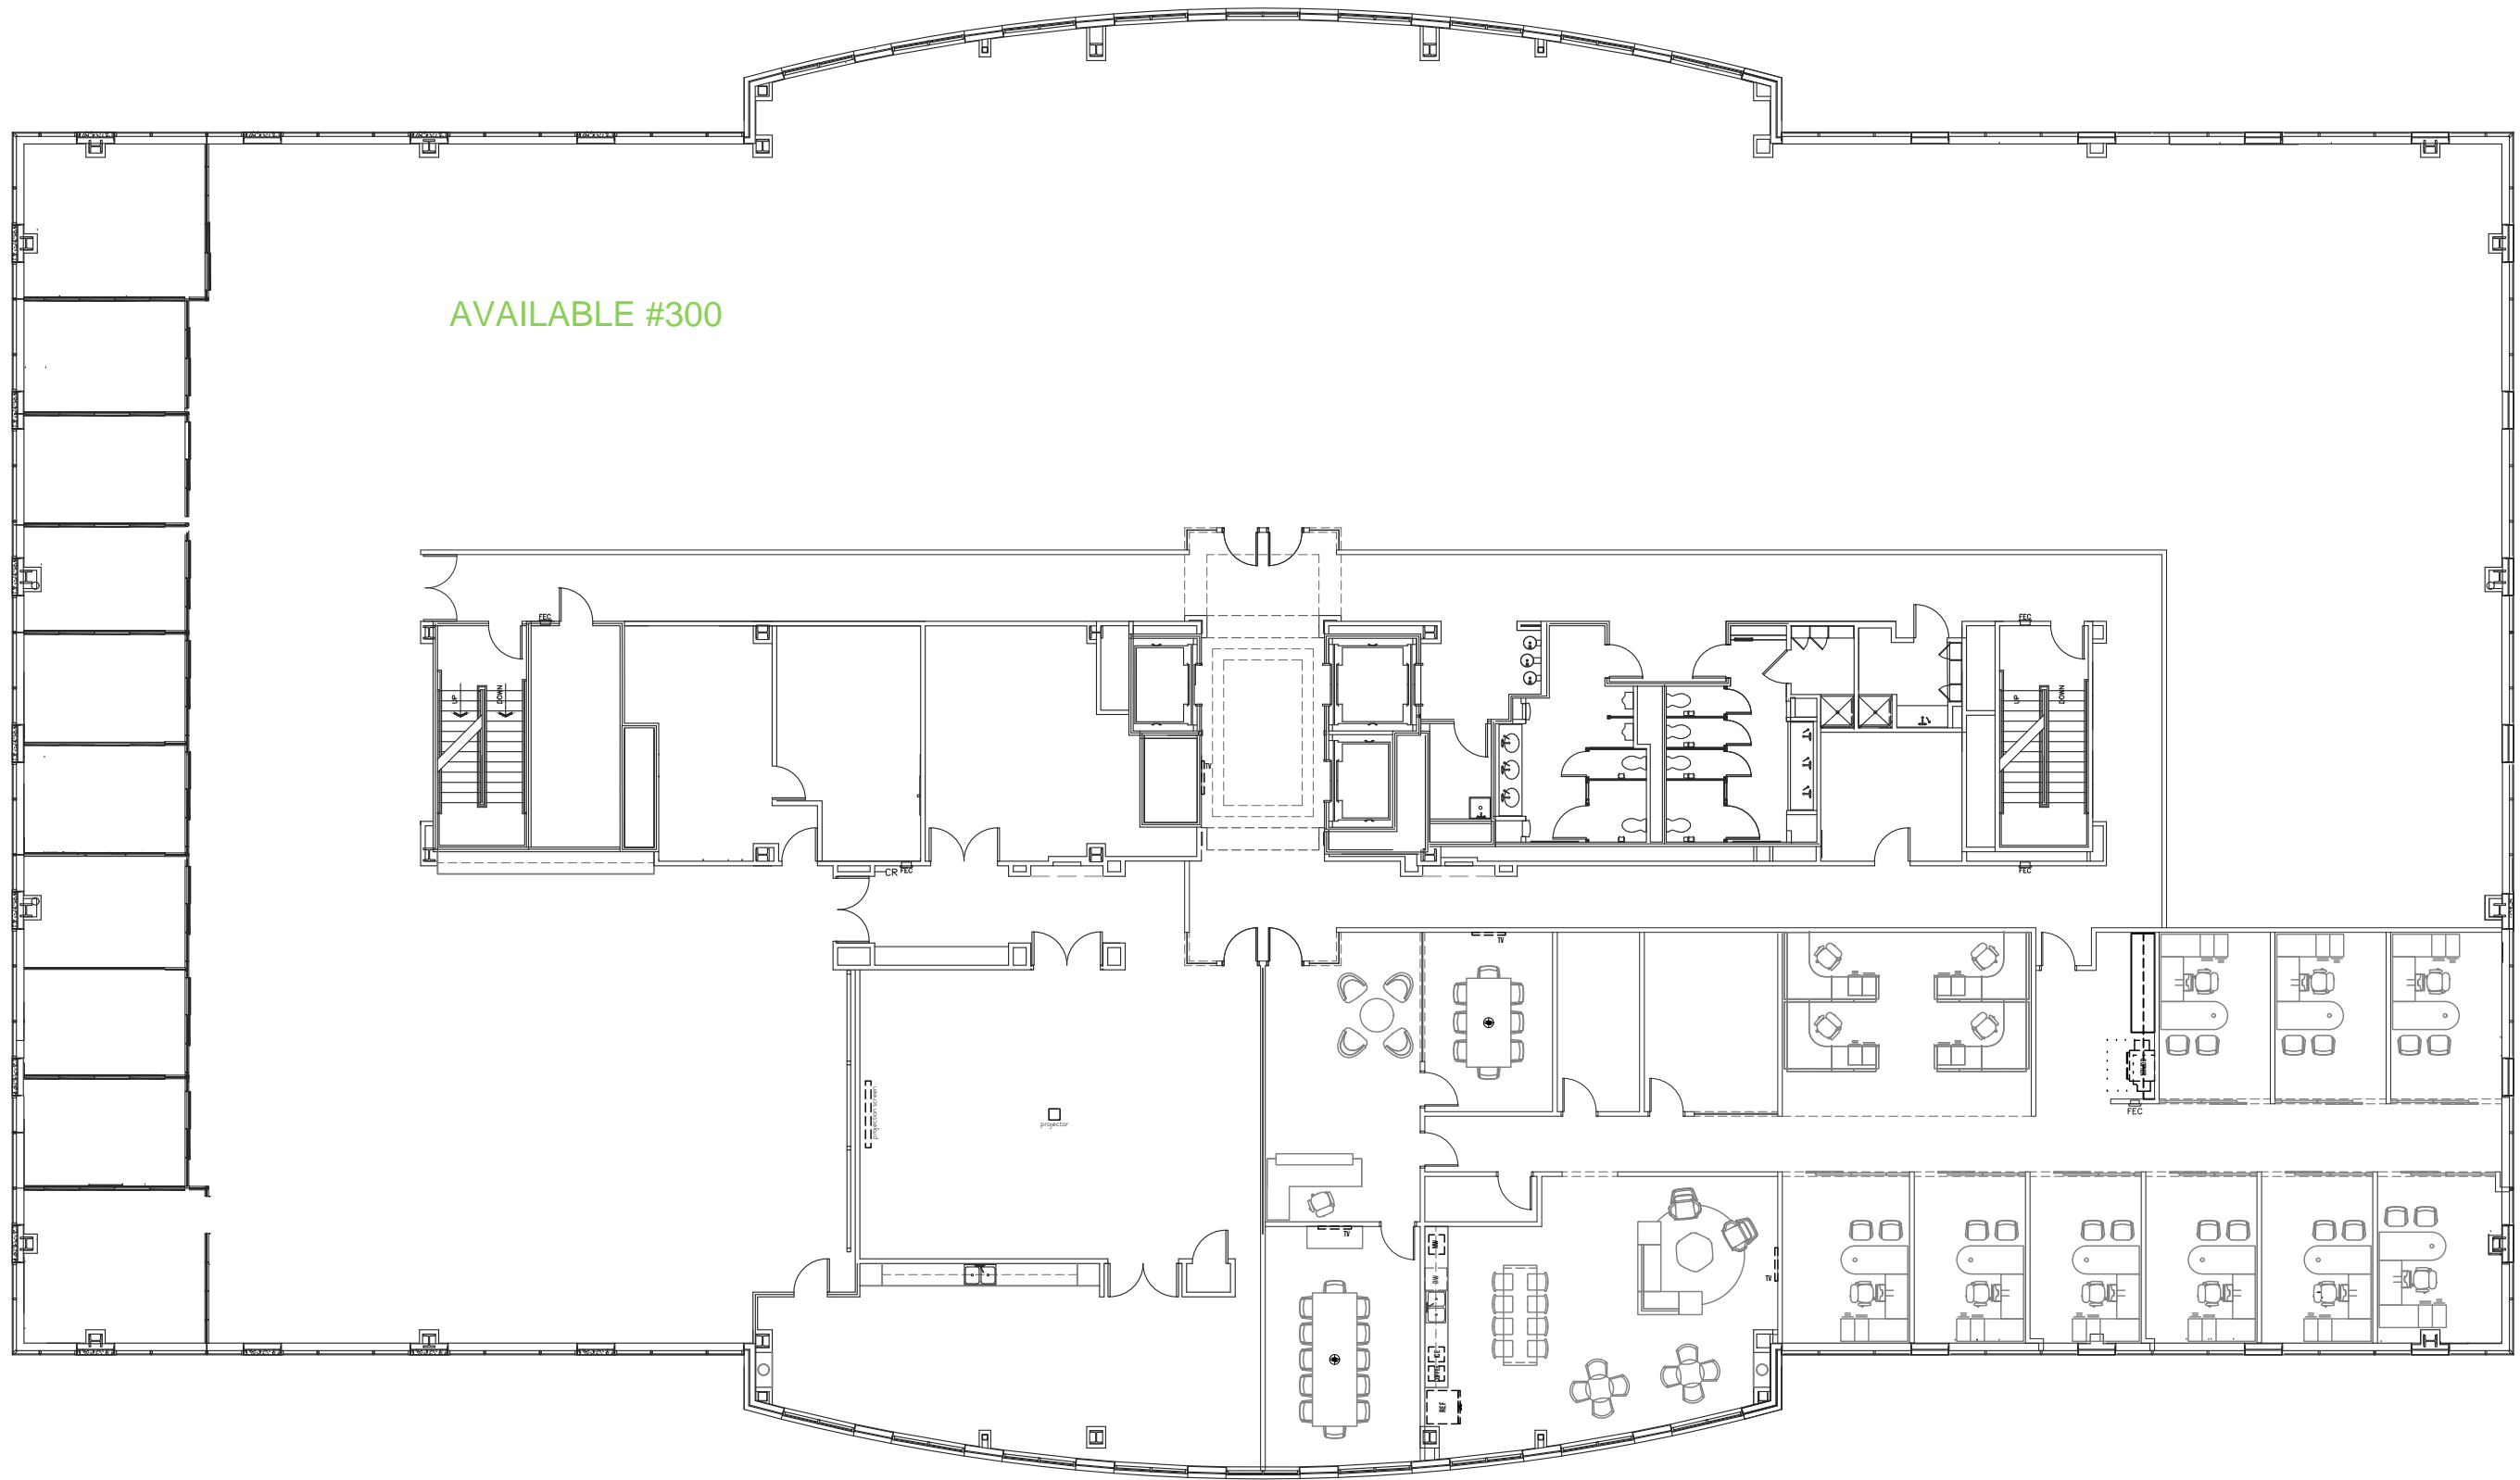

**ELEVATE**  
DESIGN  
©2016 ELEVATE DESIGN, LLC. ALL RIGHTS RESERVED.

3000 Meridian  
3RD FLOOR AS-BUILT

ISSUE DATE: 12.10.2024

SCALE: 1/16"=1'-0"



→ 65 N

4th Floor

