


Corporate

Interior

Design

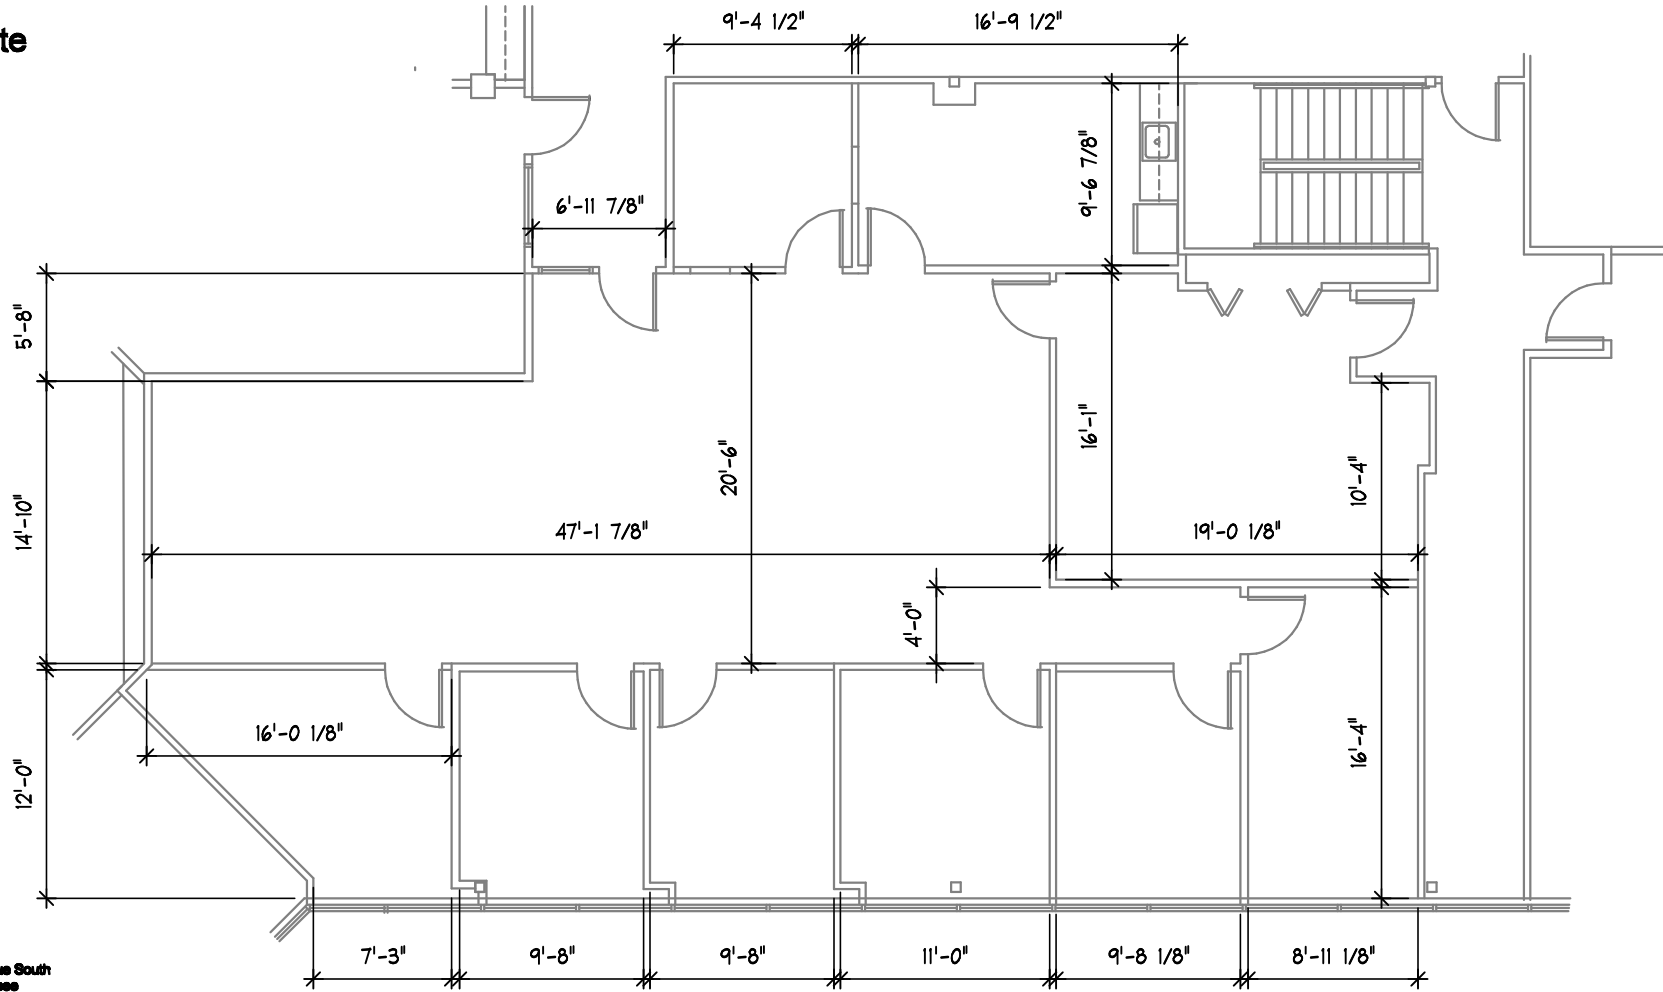

2115 Eighth Avenue South
Nashville, Tennessee
37204

PH: (615) 728-1141
FAX: (615) 728-1008

SUITE 125 LOCATION: BRENTWOOD COMMONS I, BRENTWOOD, TN		DATE: 8/1/2019
RE: AS-BUILT FLOOR PLAN SCALE: NOT TO SCALE		SHEET: 1 OF 1 JOB #: 8990-000