


Corporate

Interior

Design

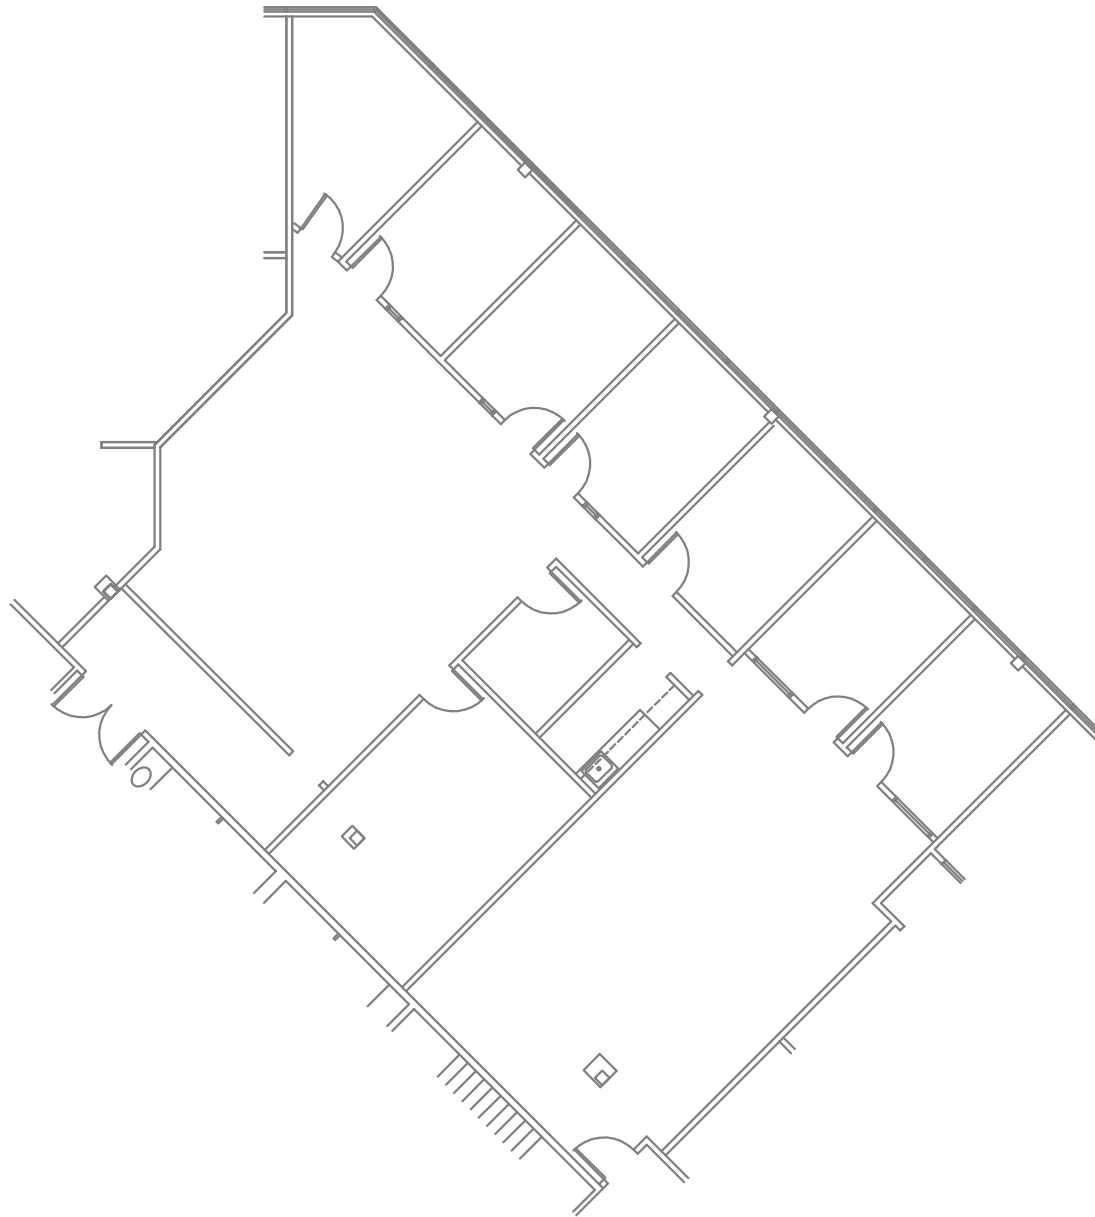

2115 Eighth Ave. South
Nashville, Tennessee
37204

PH: (615) 726-1141
FAX: (615) 726-1098

BRENTWOOD COMMONS I 750 OLD HICKORY BLVD. BRENTWOOD, TN	FLOOR: SECOND FLOOR SUITE: 254	3,487 RSF	DATE: 1/6/2020
	AS-BUILT PLAN SCALE: NOT TO SCALE		JOB #: 8990-000