


Corporate

Interior

Design

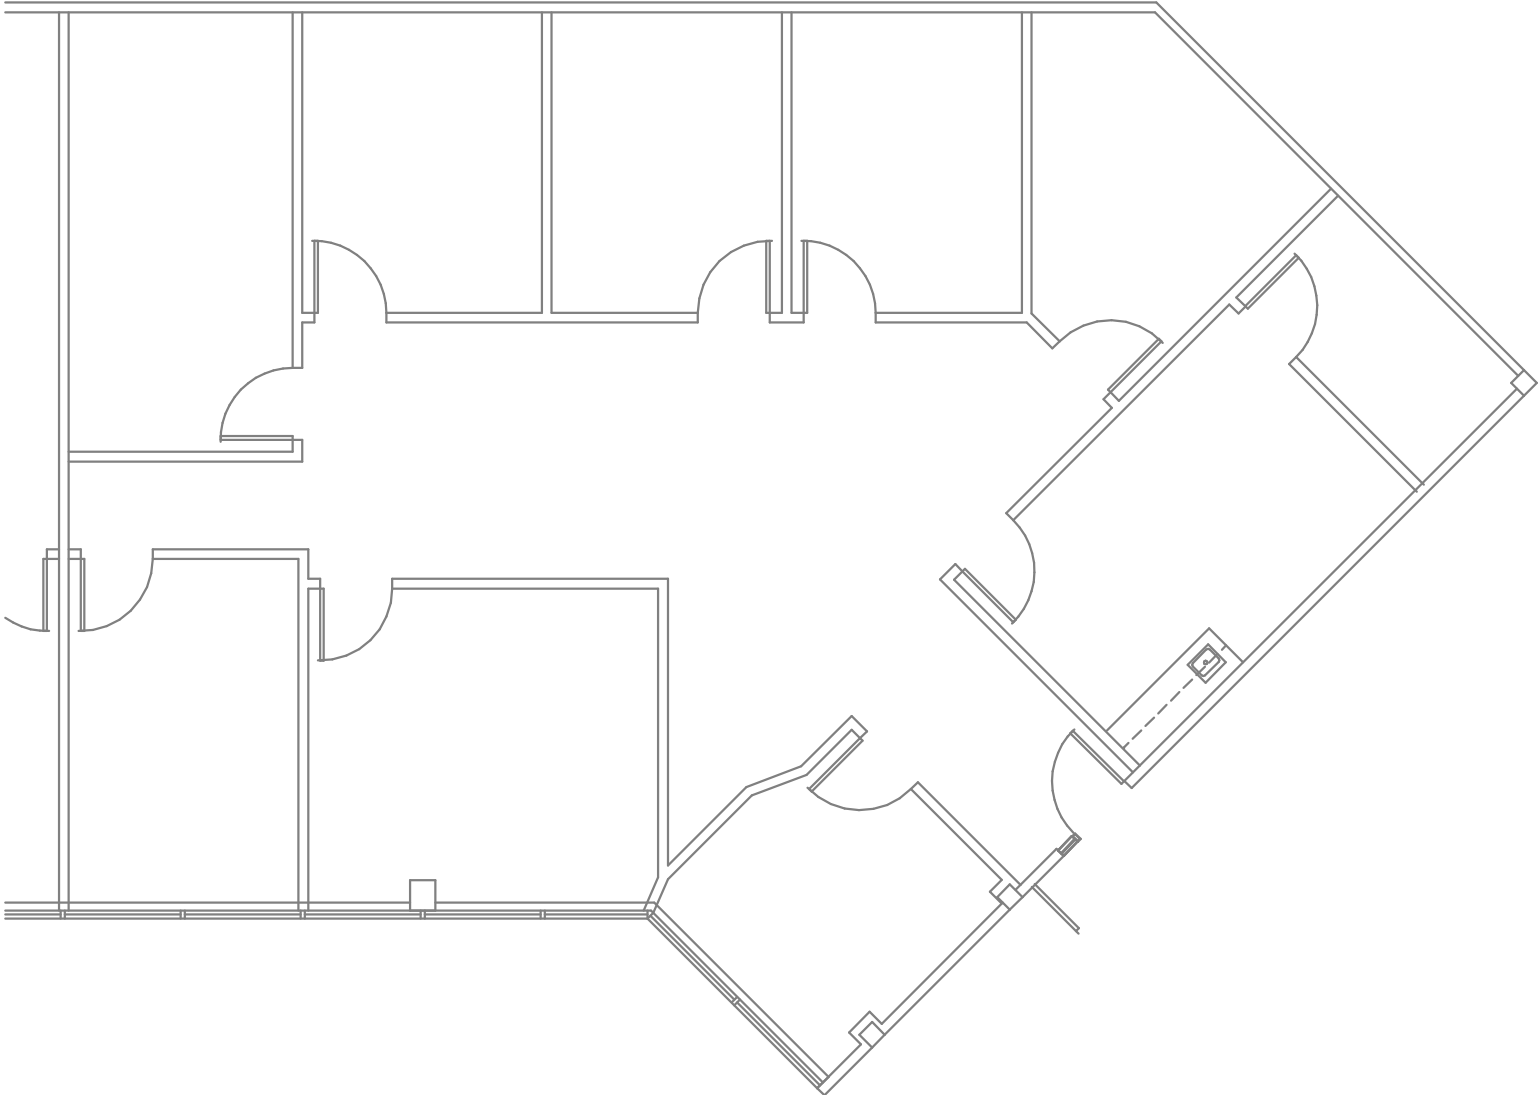

2115 Eighth Ave. South
Nashville, Tennessee
37204

PH: (615) 728-1141
FAX: (615) 728-1088

BRENTWOOD COMMONS I 750 OLD HICKORY BLVD. BRENTWOOD, TN	FLOOR: SECOND FLOOR SUITE: 286	DATE: 10/8/2018
	AS-BUILT PLAN SCALE: 1/8" = 1'-0"	JOB #: 8990-000