


Corporate

Interior

Design

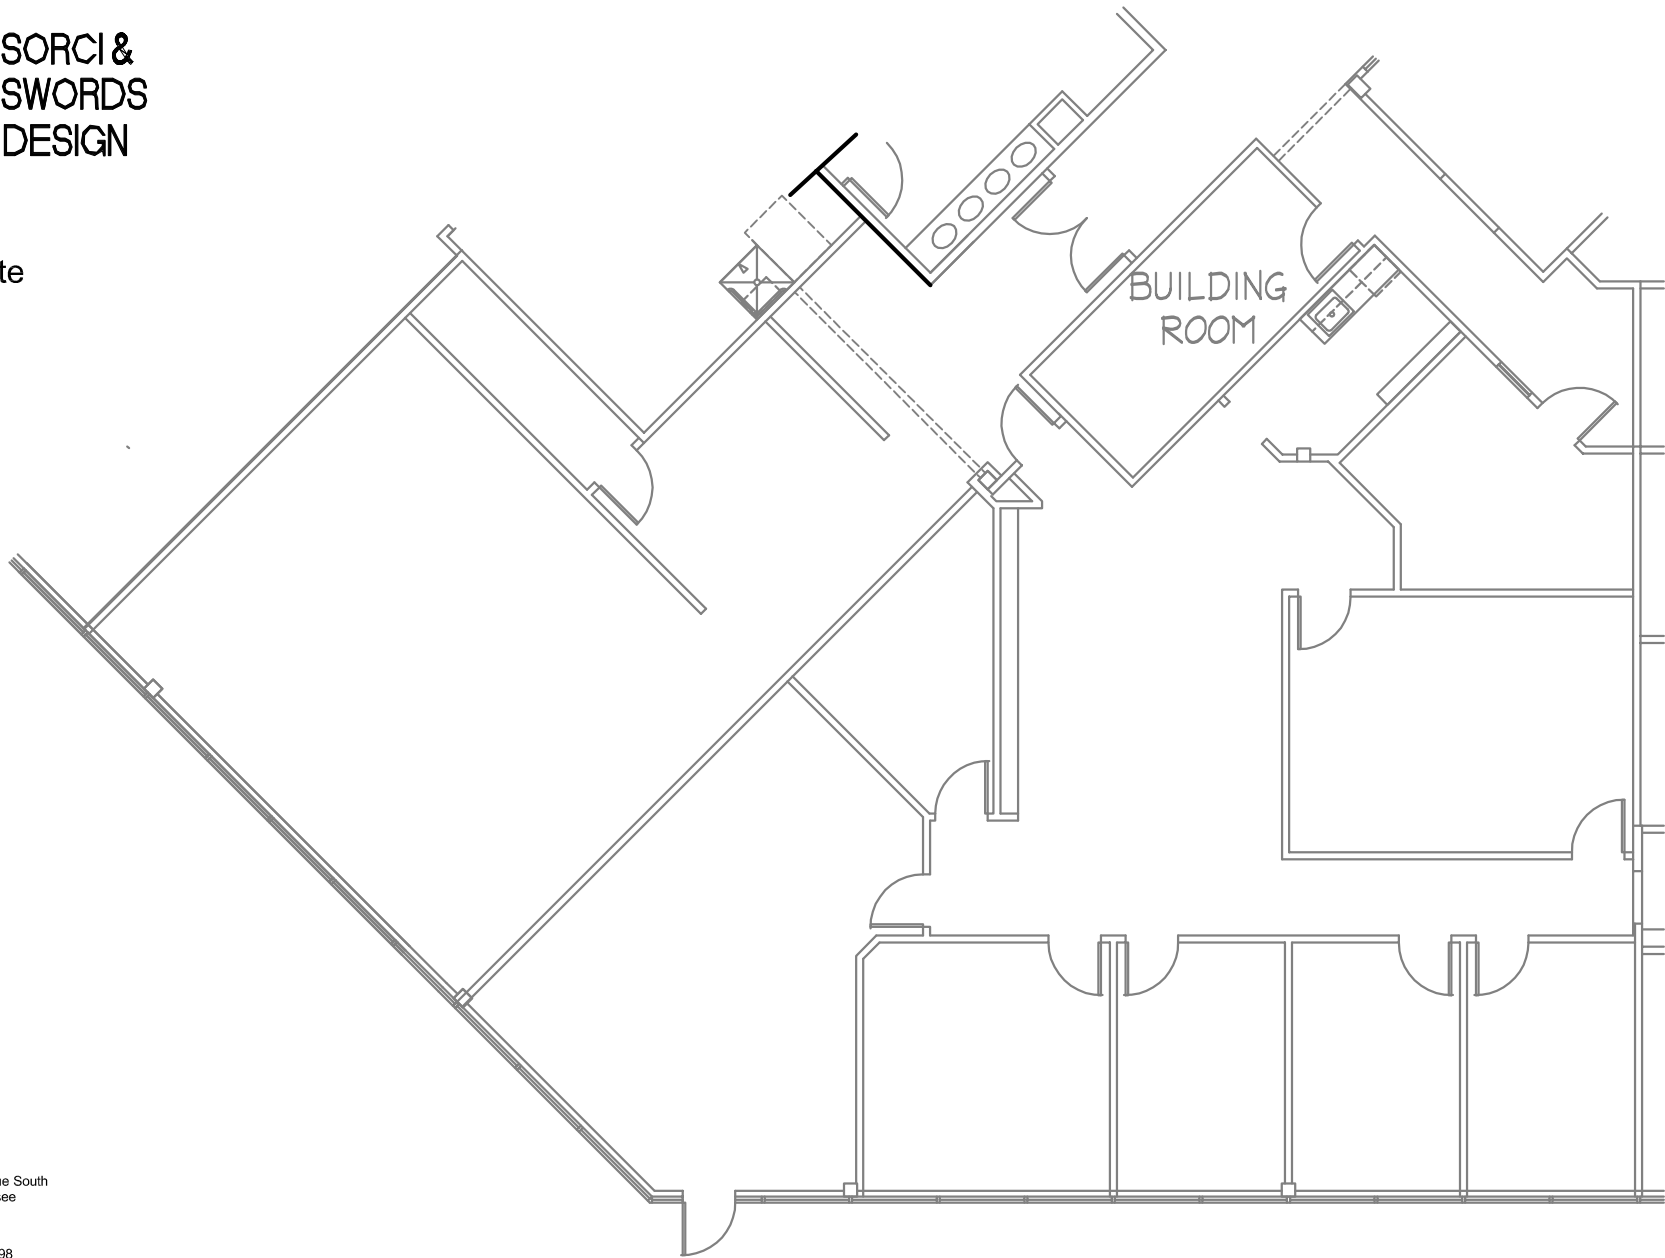

2115 Elgth Avenue South
Nashville, Tennessee
37204

PH:(615) 726-1141
FAX: (615) 726-1098

PROJECT: SUITE 2-170 LOCATION: BRENTWOOD COMMONS II	DATE: 4/30/21
RE: AS-BUILT FLOOR PLAN SCALE: NOT TO SCALE	SHEET: 1 OF 1 JOB #: 8990-000