


Corporate

Interior

Design

Suite 2-270

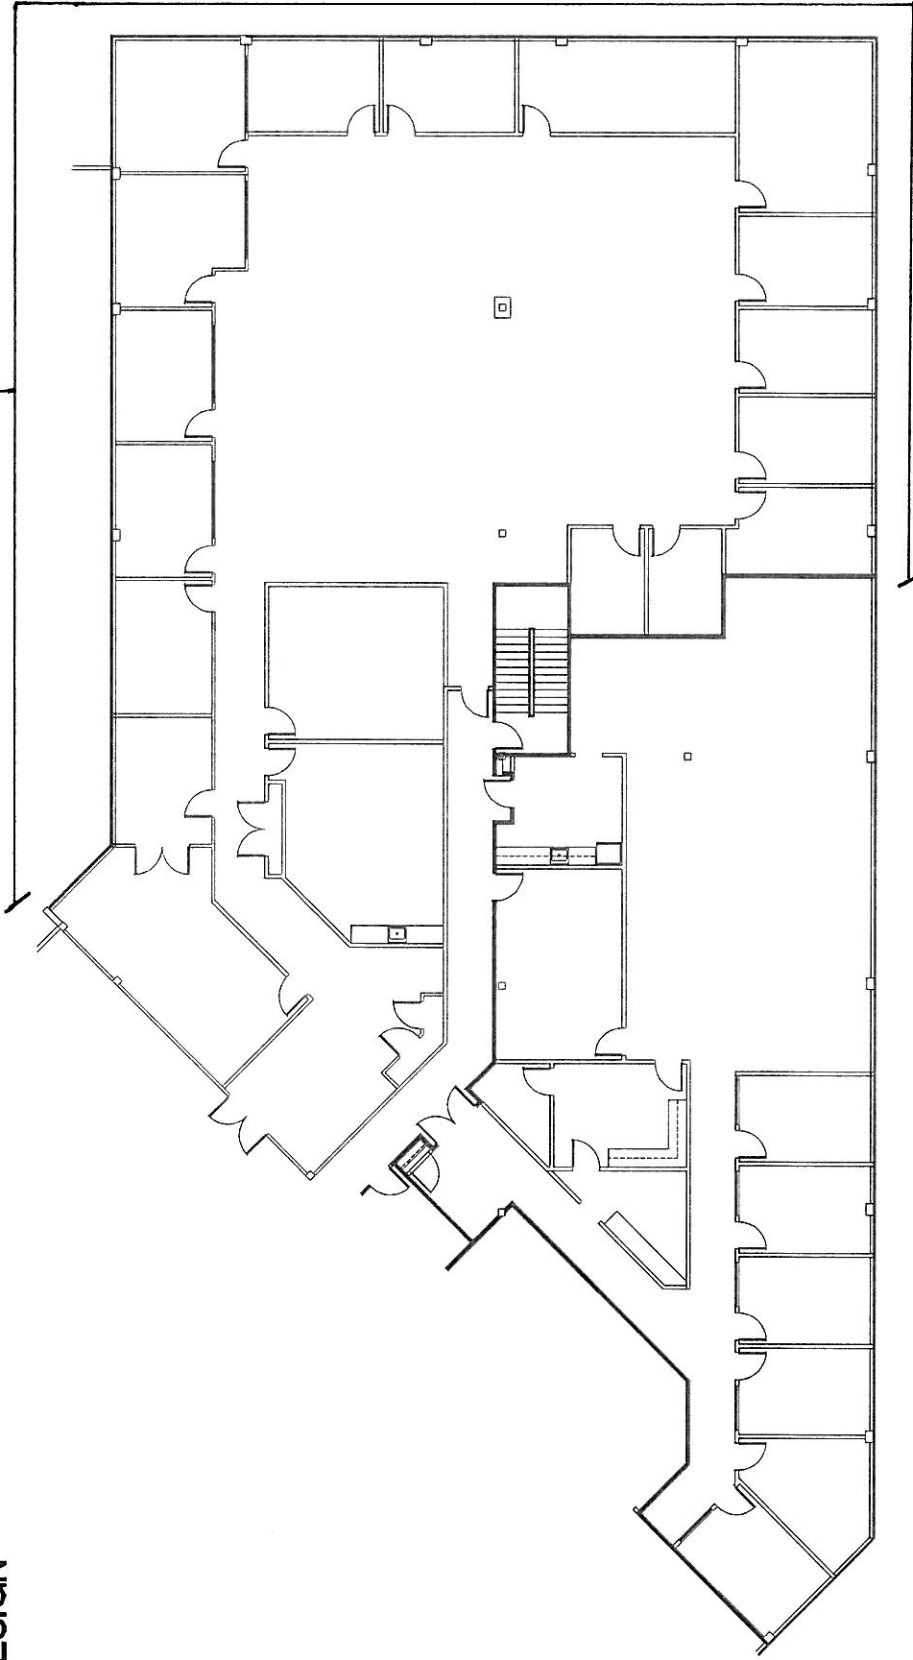

209 Tenth Avenue South
Suite 209
Nashville, Tennessee
37203-4104
PH: (615) 728-1141
FAX: (615) 728-1088

BRENTWOOD COMMONS
750 OLD HICKORY BLVD.
BRENTWOOD, TN

FLOOR: SECOND FLOOR/ BUILDING II
SUITES 260-270
AS-BUILT
SCALE: NOT TO SCALE

DATE: 3/10/2009
JOB #: 8990-000