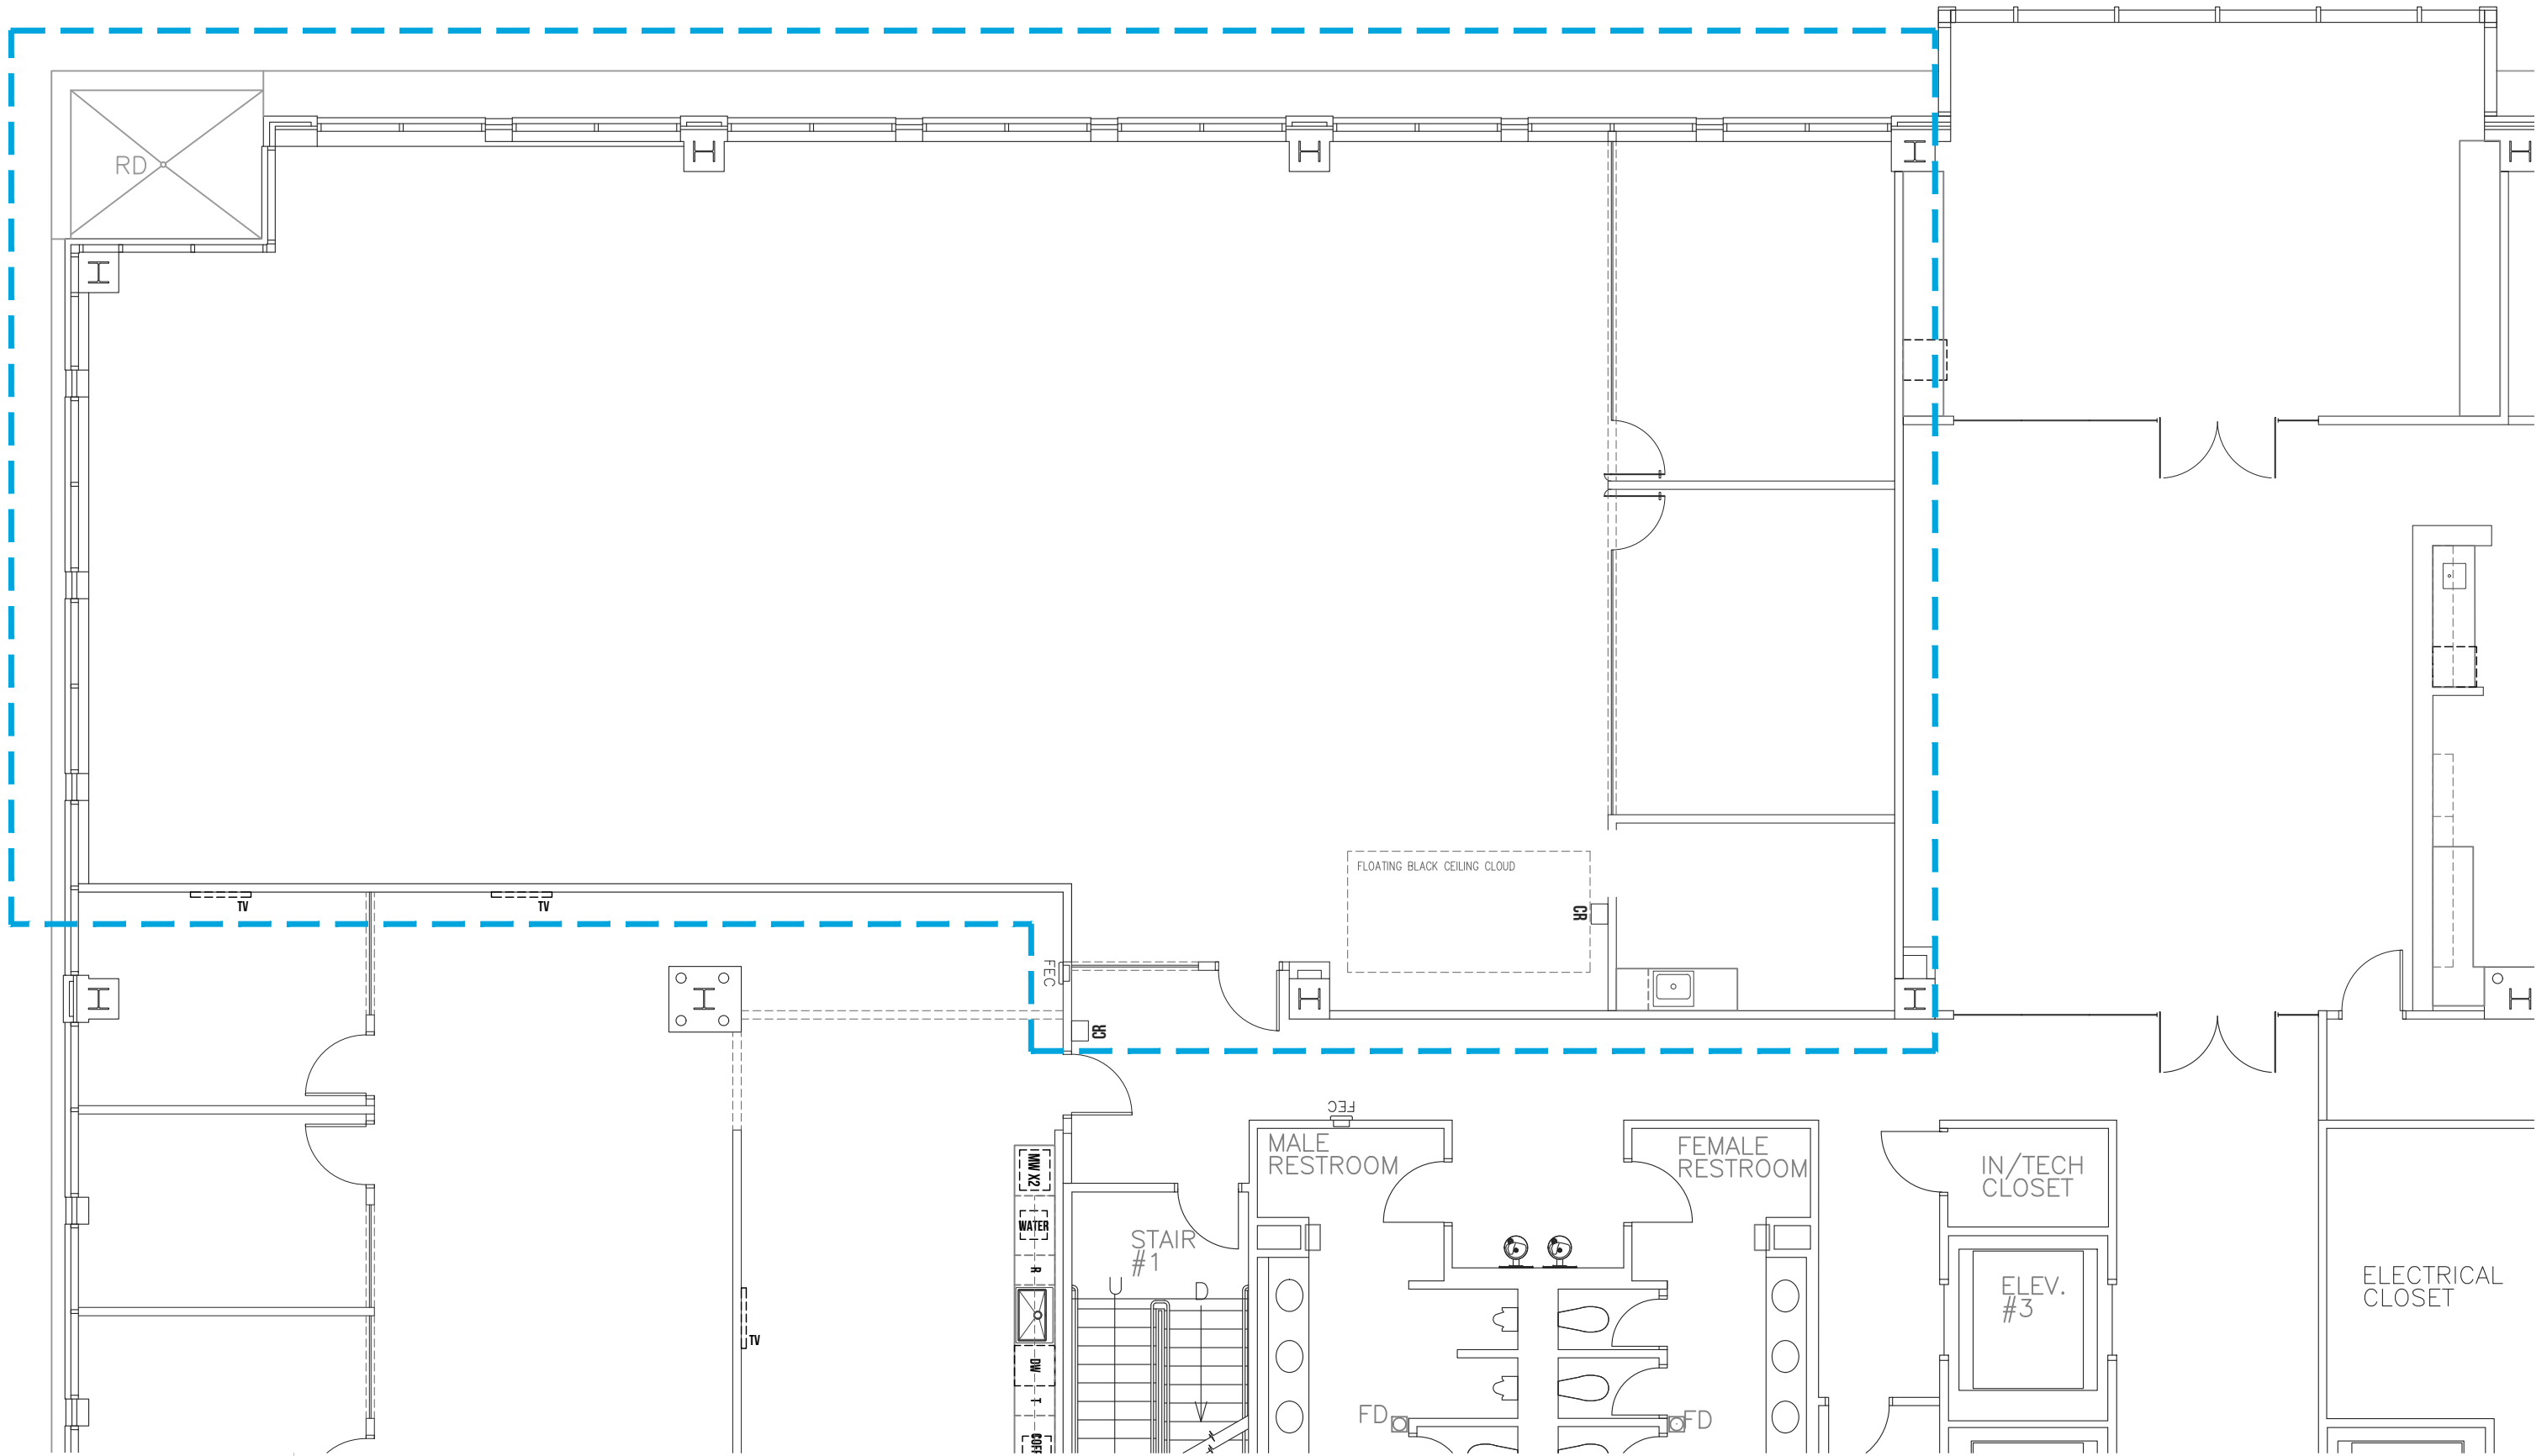


ELEVATE
DESIGN

©2016 ELEVATE DESIGN, LLC. ALL RIGHTS RESERVED.

McEwen Southside, 2nd Floor Suite

AS-BUILT

ISSUE DATE:

02.05.2026

SCALE: 1/8"=1'-0"

