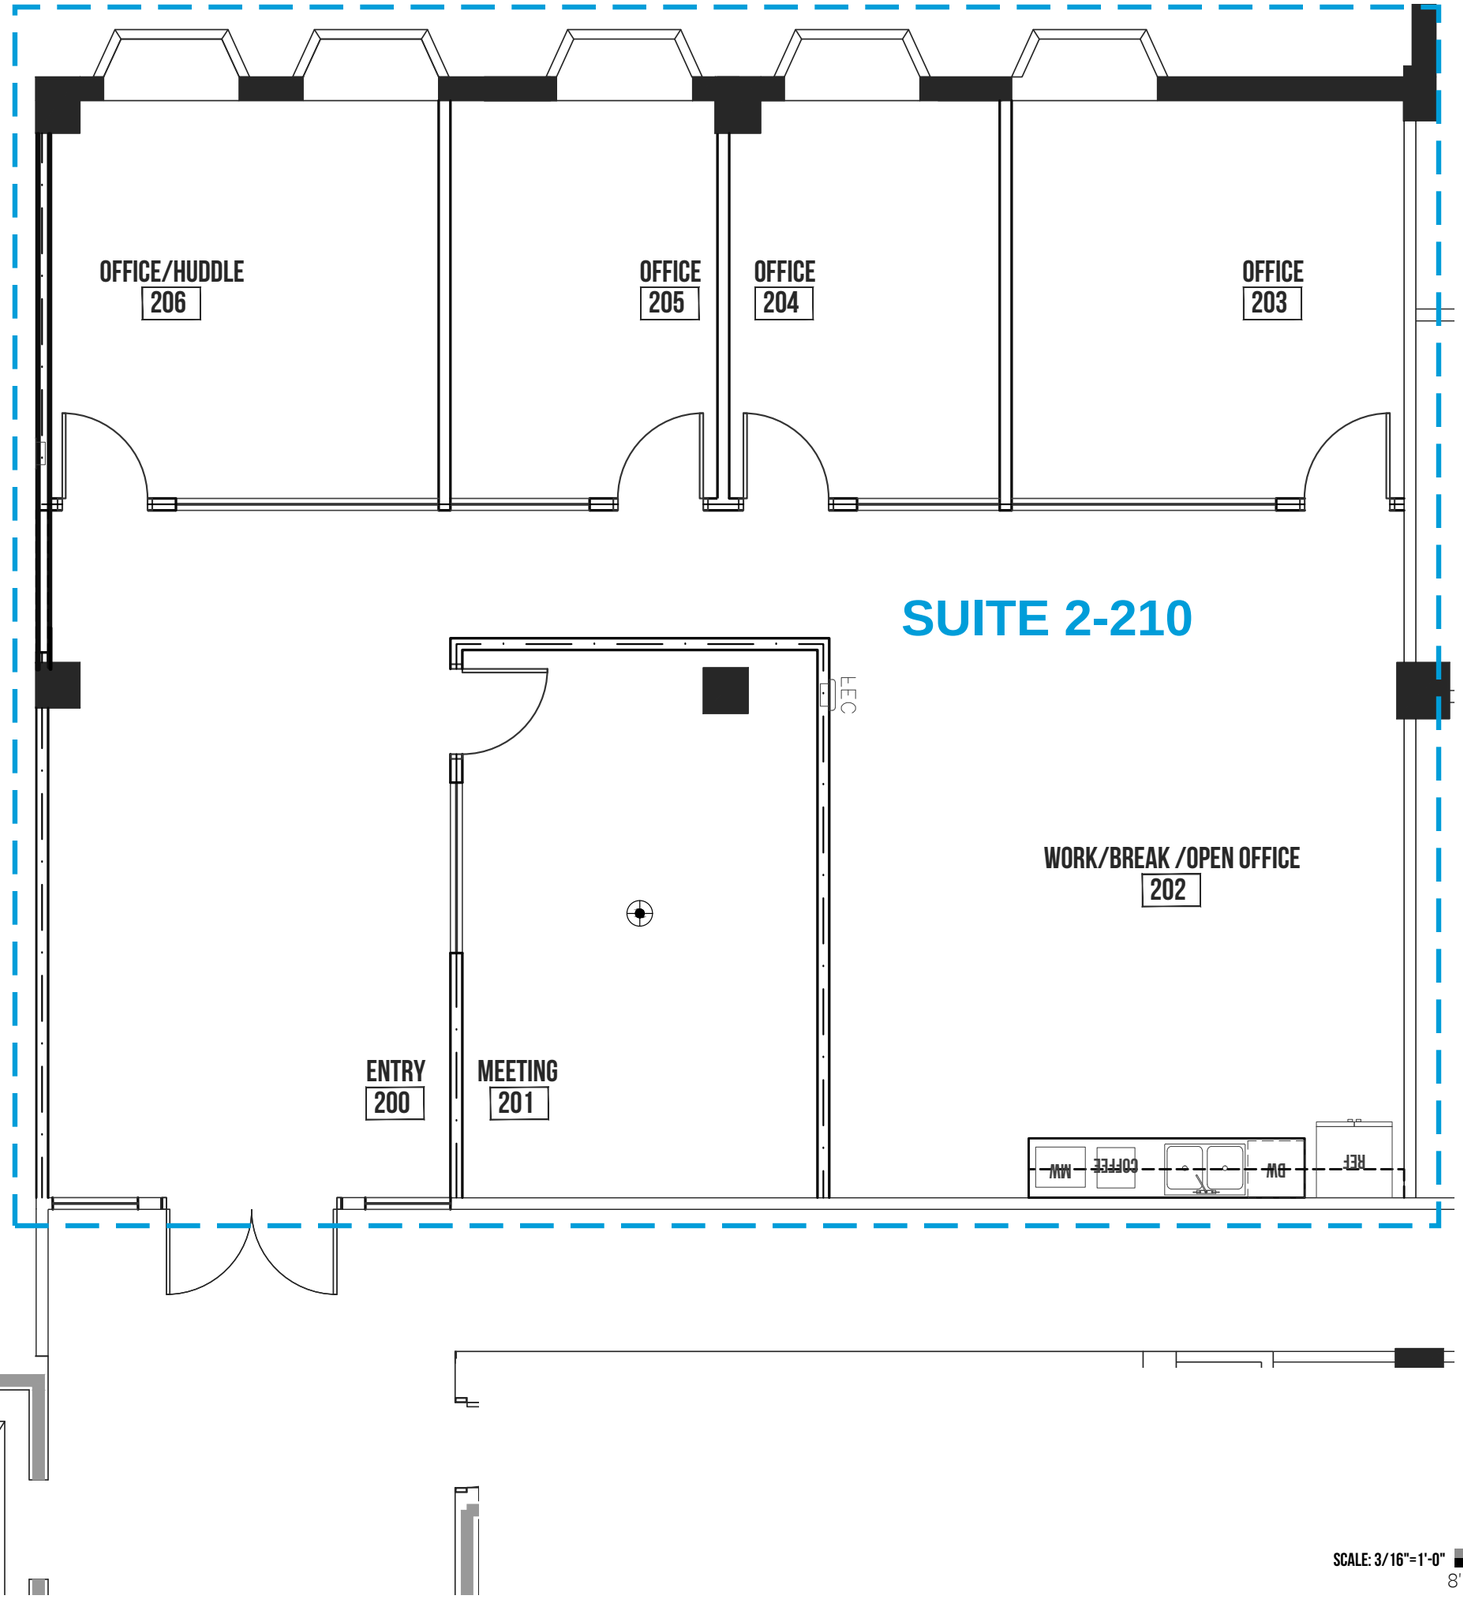


BOYLE

©2016 ELEVATE DESIGN, LLC ALL RIGHTS RESERVED.

Boyle @ EP II

EASTPARK II SUITE 2-210

ISSUE DATE: 05.10.2023

SCALE: 3/16"=1'-0"

8' 4' 0 8'